


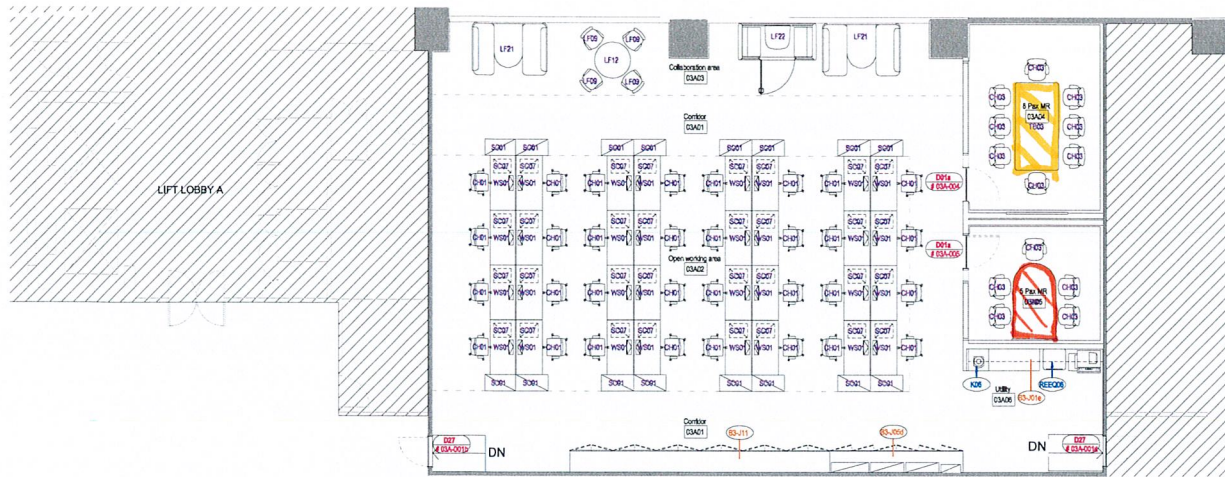

- TB01 5 Pax bullet table 1PCS
TB08 8 Pax meeting table 1PCS

L3A Room Schedule		
Number	Name	Area
03A01	Corridor	77.6 m²
03A02	Open working area	85.8 m²
03A03	Collaboration area	27.1 m²
03A04	8 Pax MR	19.4 m²
03A05	5 Pax MR	12.1 m²
03A06	Utility	2.3 m²
Grand total		224.2 m²

L3A GENERAL ARRANGEMENT PLAN
SCALE: 1 : 100

Room Number
Level



SHOPDRAWING APPROVAL

APPROVAL IS ONLY FOR GENERAL CONFORMANCE WITH THE DESIGN CONCEPT OF THE PROJECT AND THE INFORMATION GIVEN IN THE CONTRACT DOCUMENTS. CONTRACTOR IS RESPONSIBLE FOR DIMENSIONS TO BE CONFIRMED AND CORRELATED AT THE JOB SITE. INFORMATION THAT PERTAINS SOLELY TO THE FABRICATION PROCESS OR TO THE MEANS AND METHODS OF CONSTRUCTION; COORDINATION OF THE WORK OF ALL TRADES; AND PERFORMING ALL WORK IN A SAFE AND SATISFACTORY MANNER. THIS APPROVAL DOES NOT RELIEVE THE CONTRACTOR OF RESPONSIBILITY TO COMPLY WITH THE CONTRACT DRAWINGS AND DOCUMENTS.

☐ APPROVED ☐ REVISE AND RESUBMIT
☐ APPROVED WITH COMMENTS (NO RESUBMISSION REQUIRED) ☐ REJECTED

BY: _____ DATE: _____
ADDRESS: _____

SHOP DRAWING

1	FOR CONSTRUCTION	01.03.26
S/NO	AMENDMENT	DATE

CLIENT:
SINGAPORE AIRLINES

1 CHANGI BUSINESS PARK CENTRAL 1,
SINGAPORE 486336



PROJECT MANAGER:
JONES LANG LASALLE, IP, INC

PAYA LEBAR QUARTER, TOWER 2, #10-08,
1 PAYA LEBAR LINK, SINGAPORE 408533
TEL: +65 6438 6633



INTERIOR DESIGNER:
JONES LANG LASALLE, IP, INC

PAYA LEBAR QUARTER, TOWER 2, #10-08,
1 PAYA LEBAR LINK, SINGAPORE 408533
TEL: +65 6438 6633



M&E CONSULTANTS:
W2SQUARE CONSULTANCY PTE LTD

208 TOA PAYOH N, #06-12/14,
SINGAPORE 310093



LIGHTING CONSULTANT:
LIGHT COLLAB LLP

65 MAHARAJA ROAD, #03-01,
SINGAPORE 208553
TEL: (65) 6633 7511

MAIN CONTRACTOR:
CRAFTWORK PTE LTD

81 TAYLOR LANE,
TAC AP03-01, SINGAPORE 787502
TEL: (65) 6966 1705




M&E CONTRACTOR:
DLE M&E PTE LTD

2 KNO BUNK NEW #05-00,
600 BOUT TECH PARK 1,
SINGAPORE 319442
TEL: 67476551
FAX: 67481183

PROJECT TITLE:
REFURBISHMENT WORK TO TECHSQ, STC
AND OFFICE FIT-OUT WORK TO STC NEW
ANNEXE FOR SINGAPORE AIRLINES LIMITED

DRAWING TITLE:
L3A GENERAL ARRANGEMENT PLAN

DRAWN	KY	SCALE	1:100 @ A1
CHECKED	MJ	DATE	01/03/2026
DRAWING NO	03A.101	REV	R1

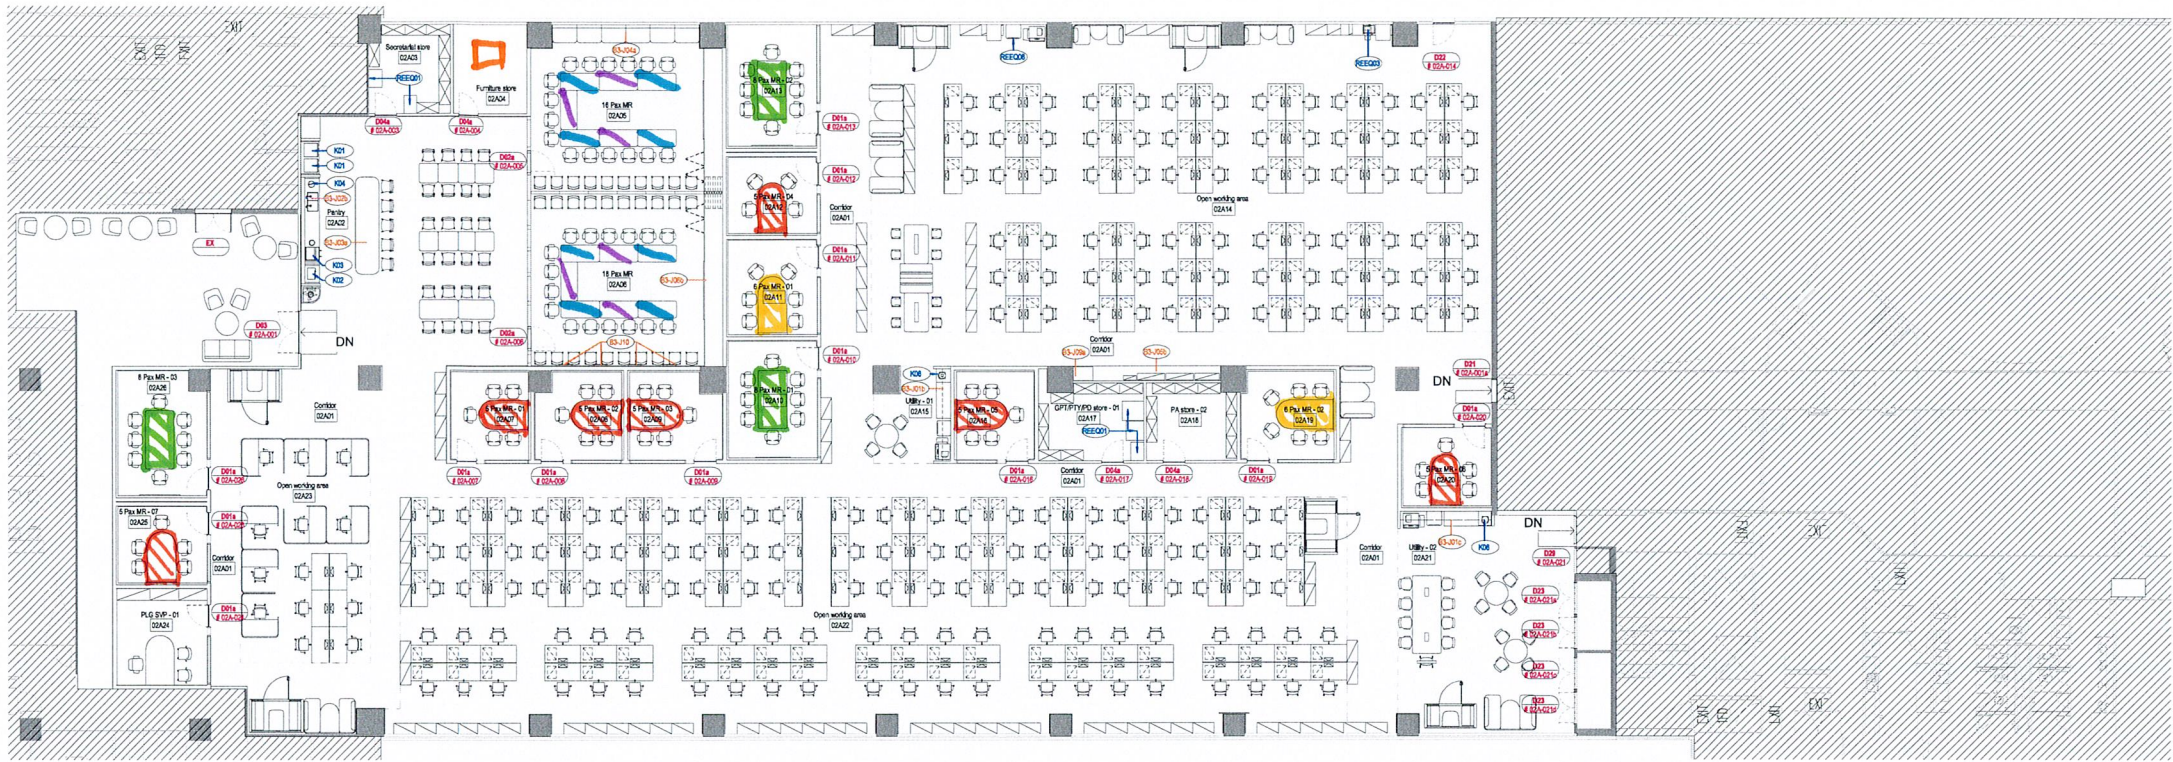

- TB01 x 7
- TB02 x 2
- TB03 x 3
- TB06A x 8
- TB06 x 6
- TB07 x 1

L2A Room Schedule		
Number	Name	Area
02A01	Corridor	260.6 m²
02A02	Pantry	84.7 m²
02A03	Secretariat store	12.1 m²
02A04	Furniture store	11.8 m²
02A05	16 Pax MR	52.9 m²
02A06	18 Pax MR	56.7 m²
02A07	5 Pax MR - 01	12.8 m²
02A08	5 Pax MR - 02	13.2 m²
02A09	5 Pax MR - 03	13.8 m²
02A10	8 Pax MR - 01	18.5 m²
02A11	6 Pax MR - 01	15 m²
02A12	5 Pax MR - 04	12.2 m²
02A13	8 Pax MR - 02	19.1 m²
02A14	Open working area	321.8 m²
02A15	Utility - 01	11.4 m²
02A16	5 Pax MR - 05	12.3 m²
02A17	GPT/PTY/PD store - 01	13.8 m²
02A18	PA store - 02	11.8 m²
02A19	6 Pax MR - 02	14.4 m²
02A20	5 Pax MR - 06	12.4 m²
02A21	Utility - 02	65.4 m²

L2A Room Schedule		
Number	Name	Area
02A22	Open working area	381.2 m²
02A23	Open working area	50.6 m²
02A24	PLG SVP - 01	15.3 m²
02A25	5 Pax MR - 07	12.5 m²
02A26	8 Pax MR - 03	19.6 m²
Grand total		1,525.7 m²

L2A GENERAL ARRANGEMENT PLAN
SCALE: 1 : 150

SHOPDRAWING APPROVAL

APPROVAL IS ONLY FOR GENERAL CONFORMANCE WITH THE DESIGN CONCEPT OF THE PROJECT AND THE INFORMATION GIVEN IN THE CONTRACT DOCUMENTS. CONTRACTOR IS RESPONSIBLE FOR DIMENSIONS TO BE CONFIRMED AND CORRELATED AT THE JOB SITE; INFORMATION THAT PERTAINS SOLELY TO THE FABRICATION PROCESS OR TO THE MEANS AND METHODS OF CONSTRUCTION; COORDINATION OF THE WORK OF ALL TRADES; AND PERFORMING ALL WORK IN A SAFE AND SATISFACTORY MANNER. THIS APPROVAL DOES NOT RELIEVE THE CONTRACTOR OF RESPONSIBILITY TO COMPLY WITH THE CONTRACT DRAWINGS AND DOCUMENTS.

☐ APPROVED ☐ REVISE AND RESUBMIT
☐ APPROVED WITH COMMENTS (NO RESUBMISSION REQUIRED) ☐ REJECTED

BY: _____ DATE: _____

ADDRESS: _____

SHOP DR

CLIENT
SINGAPORE AIRLINES

1 CHANG BUSINESS PARK CENTRAL 1, SINGAPORE 486036



PROJECT MANAGER
JONES LANG LASALLE, IP, INC

PAYA LEBAR QUARTER, TOWER 2, #10-08, 1 PAYA LEBAR LINK, SINGAPORE 408533
TEL: +65 6438 6633



INTERIOR DESIGNER
JONES LANG LASALLE, IP, INC

PAYA LEBAR QUARTER, TOWER 2, #10-08, 1 PAYA LEBAR LINK, SINGAPORE 408533
TEL: +65 6438 6633



MEP CONSULTANTS
W2SQUARE CONSULTANCY PTE LTD

808, TDA PATCH 10, #06-12/14, SINGAPORE 318963



LIGHTING CONSULTANT
LIGHT COLLAB LLP

85 MADE ROAD, #03-01, SINGAPORE 408623
TEL: (65) 6435 7511

MAIN CONTRACTOR
CRAFTWORK PTE LTD

81 TADPOLE LANE, TAG, #03-01, SINGAPORE 787502
TEL: (65) 8996 1705



MEP CONTRACTOR
DLE M&E PTE LTD

2 KNO BUNKER NEW #05-00, KNO BUNKER TECH PARK 1, SINGAPORE 109442
TEL: 67478847 FAX: 67478847


PROJECT TITLE
REFURBISHMENT WORK TO TECHSQ, STC AND OFFICE FIT-OUT WORK TO STC NEW ANNEXE FOR SINGAPORE AIRLINES LIMITED

DRAWING TITLE
L2A GENERAL ARRANGEMENT PLAN

DRAWN: KY
CHECKED: MJ
DATE: 01/03/2016
REV: R1

SCALE: 1:150 @ A1

DRAWING NO: 02A101

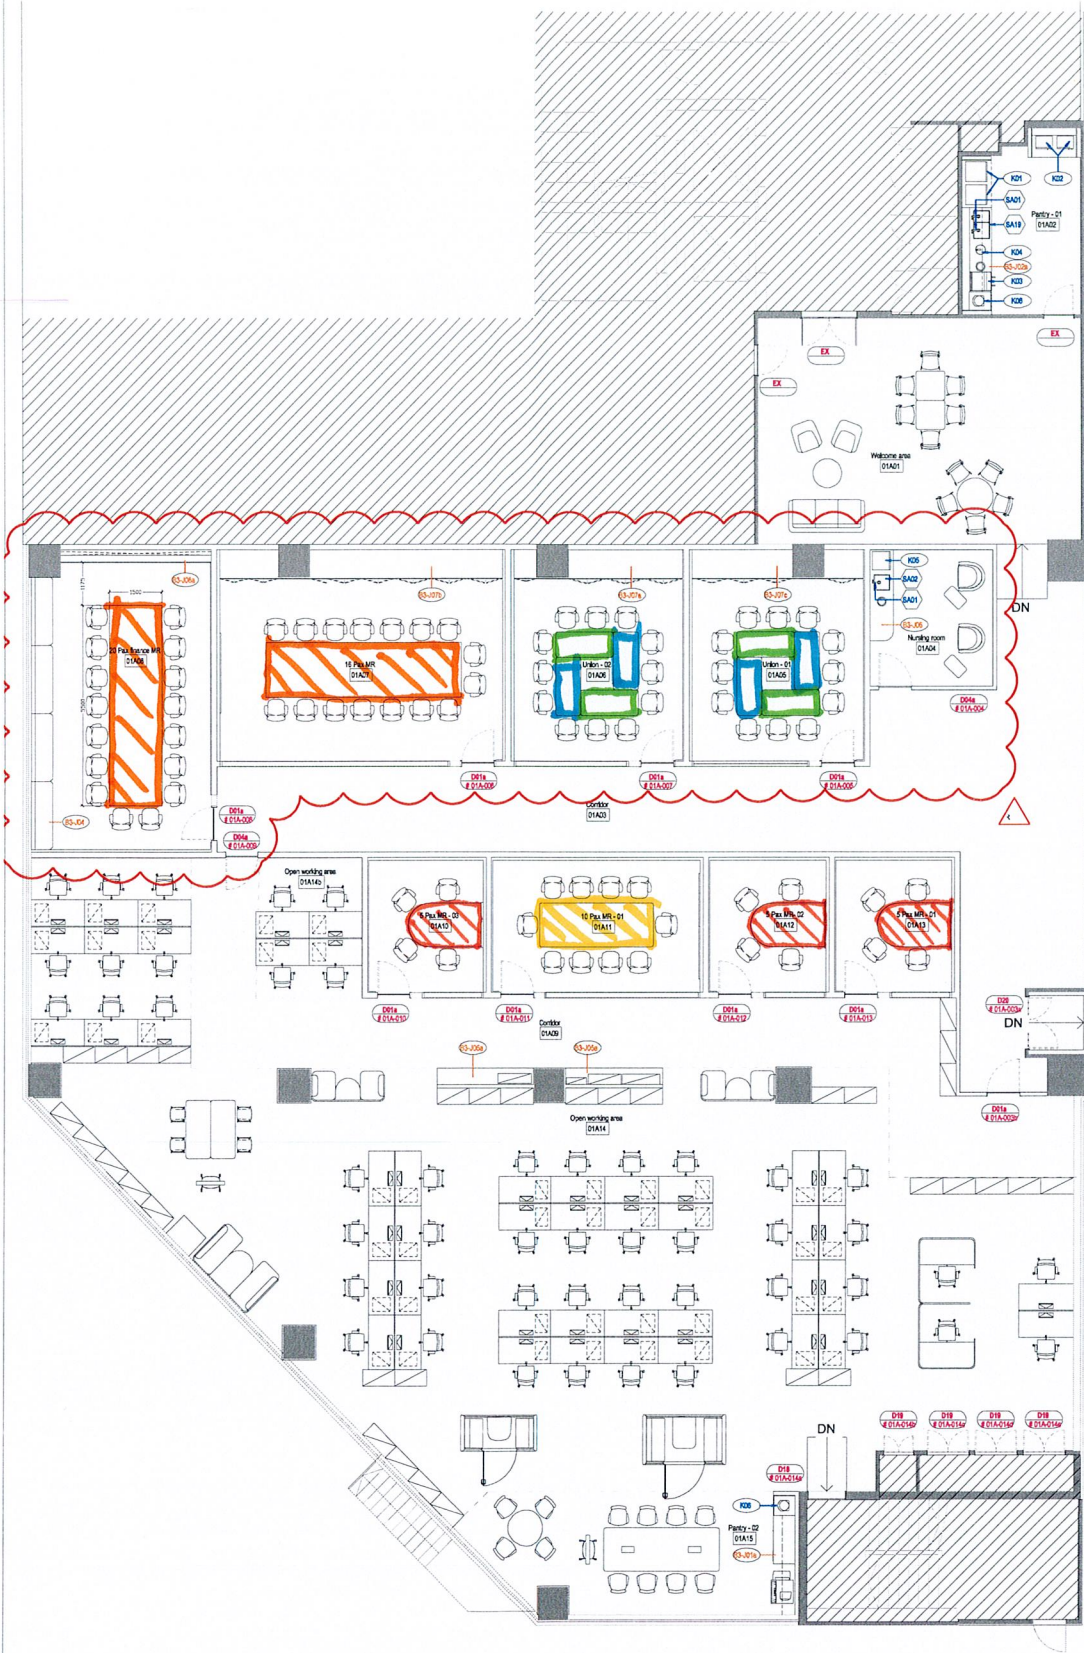

— TB01 x 3
— TB04 x 1
— TB06 x 4
— TB06A x 4
— TB09 x 2

L1A Room Schedule		
Number	Name	Area
01A01	Welcome area	55.2 m²
01A02	Pantry - 01	15.5 m²
01A03	Corridor	97.1 m²
01A04	Nursing room	12.8 m²
01A05	Union - 01	27.5 m²
01A06	20 Pax MR	46.4 m²
01A07	Union - 02	27.5 m²
01A08	20 Pax finance MR	42.2 m²
01A09	Corridor	61.2 m²
01A10	5 Pax MR - 03	12.3 m²
01A11	10 Pax MR - 01	22 m²
01A12	5 Pax MR - 02	12.4 m²
01A13	5 Pax MR - 01	12.3 m²
01A14	Open working area	282.5 m²
01A14b	Open working area	11.4 m²
01A15	Pantry - 02	29.5 m²
Grand total		767.8 m²

SHOPDRAWING APPROVAL

APPROVAL IS ONLY FOR GENERAL CONFORMANCE WITH THE DESIGN CONCEPT OF THE PROJECT AND THE INFORMATION GIVEN IN THE CONTRACT DOCUMENTS. CONTRACTOR IS RESPONSIBLE FOR DIMENSIONS TO BE CONFIRMED AND CORRELATED AT THE JOB SITE; INFORMATION THAT PERTAINS SOLELY TO THE FABRICATION PROCESS OR TO THE MEANS AND METHODS OF CONSTRUCTION; COORDINATION OF THE WORK OF ALL TRADES; AND PERFORMING ALL WORK IN A SAFE AND SATISFACTORY MANNER. THIS APPROVAL DOES NOT RELIEVE THE CONTRACTOR OF RESPONSIBILITY TO COMPLY WITH THE CONTRACT DRAWINGS AND DOCUMENTS.

☐ APPROVED ☐ REVISE AND RESUBMIT
☐ APPROVED WITH COMMENTS (NO RESUBMISSION REQUIRED) ☐ REJECTED

BY: _____ DATE: _____

ADDRESS: _____

SHOP DRAWING

CLIENT:
SINGAPORE AIRLINES

1 QIANQI BUSINESS PARK CENTRAL 1,
SINGAPORE 480336



PROJECT MANAGER:
JONES LANG LASALLE, IP, INC

PAYA LEBAR QUARTER, TOWER 2, #10-08,
1 PAYA LEBAR LINK, SINGAPORE 408533
TEL: +65 6438 8633



INTERIOR DESIGNER:
JONES LANG LASALLE, IP, INC

PAYA LEBAR QUARTER, TOWER 2, #10-08,
1 PAYA LEBAR LINK, SINGAPORE 408533
TEL: +65 6438 8633



ME CONSULTANTS:
W2SQUARE CONSULTANCY PTE LTD



808 TOA PAYOH #1, #06-12/14,
SINGAPORE 318983

LIGHTING CONSULTANT:
LIGHT COLLAB LLP

85 MAUDE ROAD, #03-01,
SINGAPORE 408622
TEL: (65) 6438 7911

MAIN CONTRACTOR:
CRAFTWORK PTE LTD

craftwork

ME CONTRACTOR:
DLE M&E PTE LTD
2 KAO BUKIT NEWMAN RD,
SINGAPORE 408533
TEL: 67478633
FAX: 67478633

PROJECT TITLE:
REFURBISHMENT WORK TO TECHSQ, STC
AND OFFICE FIT-OUT WORK TO STC NEW
ANNEXE FOR SINGAPORE AIRLINES LIMITED

DRAWING TITLE:
LIA GENERAL ARRANGEMENT PLAN

DRAWN	KY	SCALE	1:100 @ A1
CHECKED	WJ	DATE	01/03/2026
DRAWING NO.	01A101	REV.	R1

L1A GENERAL ARRANGEMENT PLAN
SCALE: 1 : 100